C.1 FACILITIES ACQUISITION: EXHIBIT 1

To support the students and implement SLA's program of instruction, the following school on Fillmore Street will be utilized. Included in this exhibit is the layout of the space.

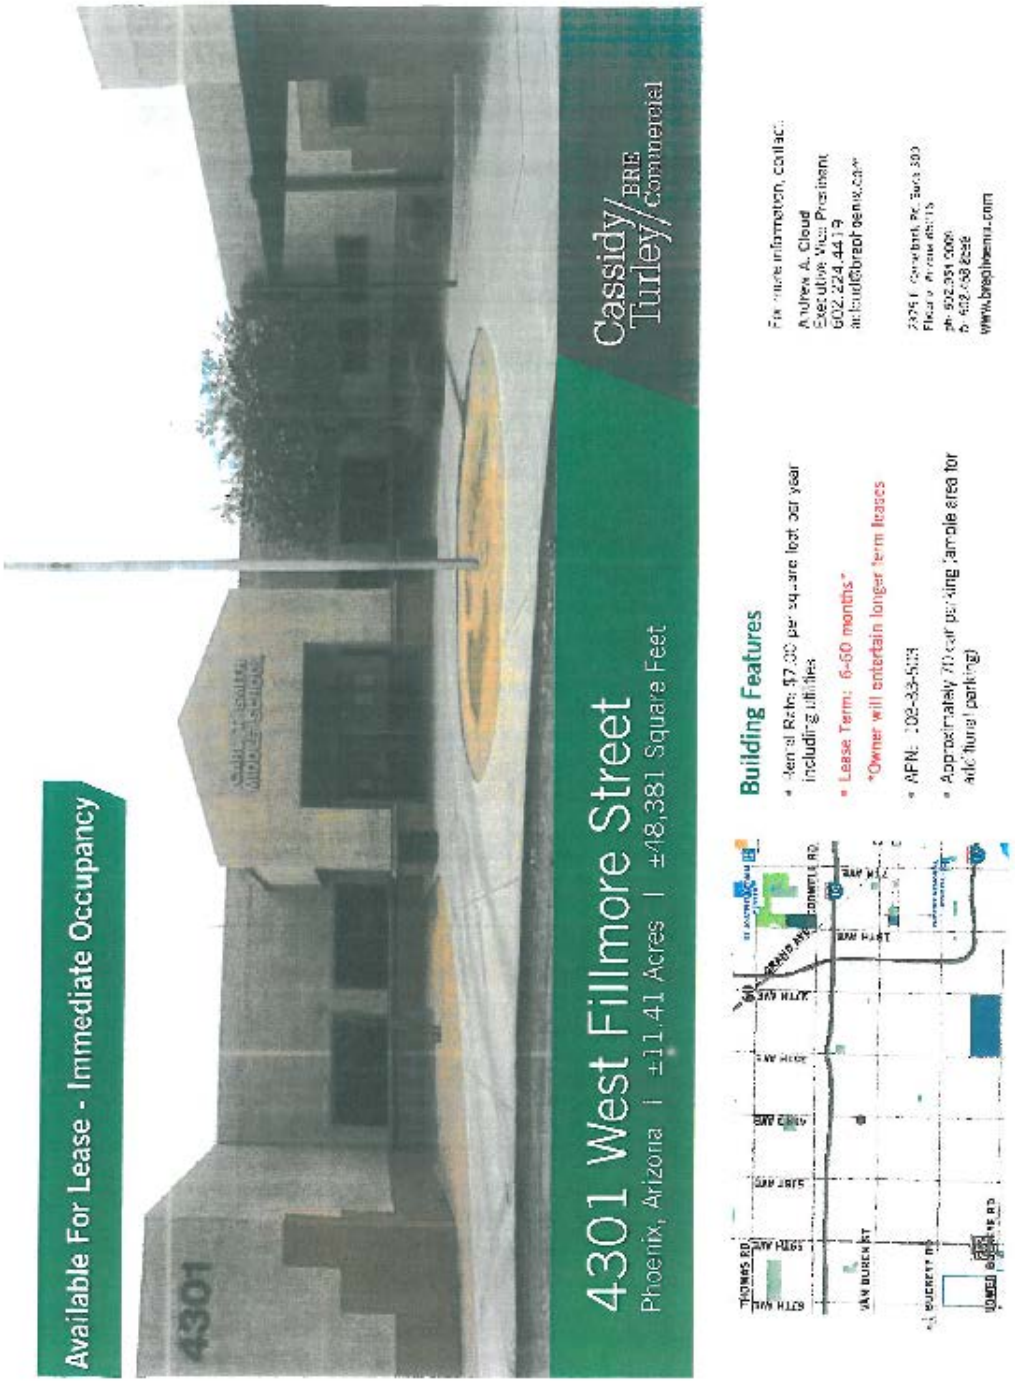

4301 West Fillmore Street

Phoenix, Arizona | ±11.41 Acres | ±48,381 Square Feet

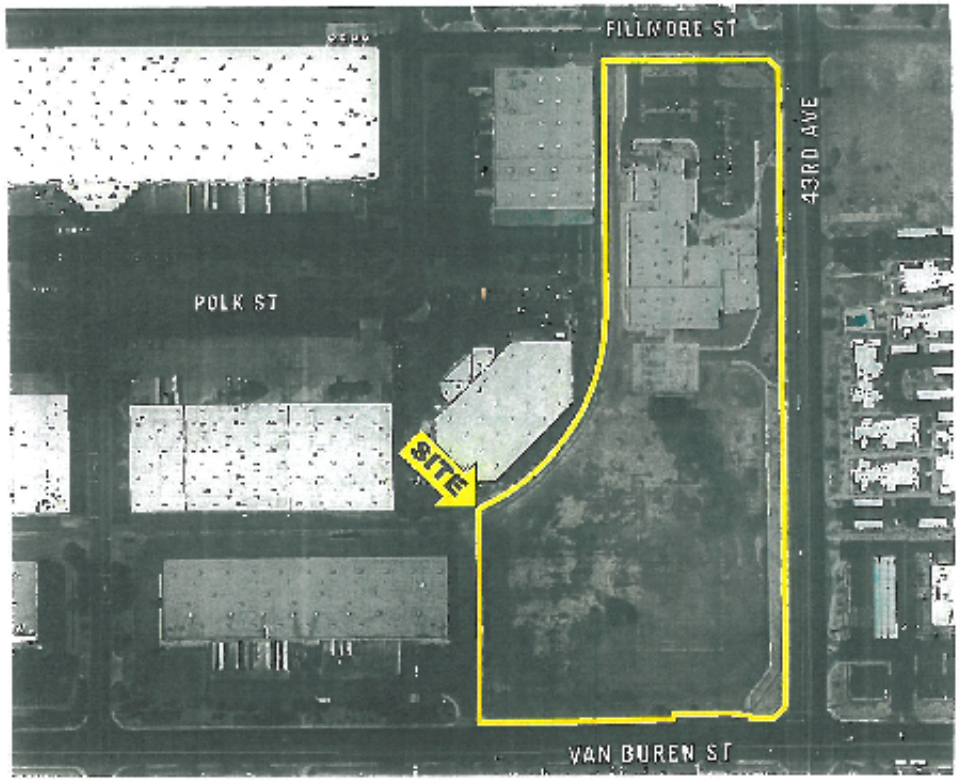

Building Features


For more information, please contact:
Andrew A. Cloud
Executive Vice President
602.224.4419
acloud@brephoenix.com

7373 E. Camelback Rd., Suite 300
Phoenix, Arizona 85251
ph. 602.994.9600
fx. 602.468.6588
www.brephoenix.com

Cassidy Turley / BRE Commercial

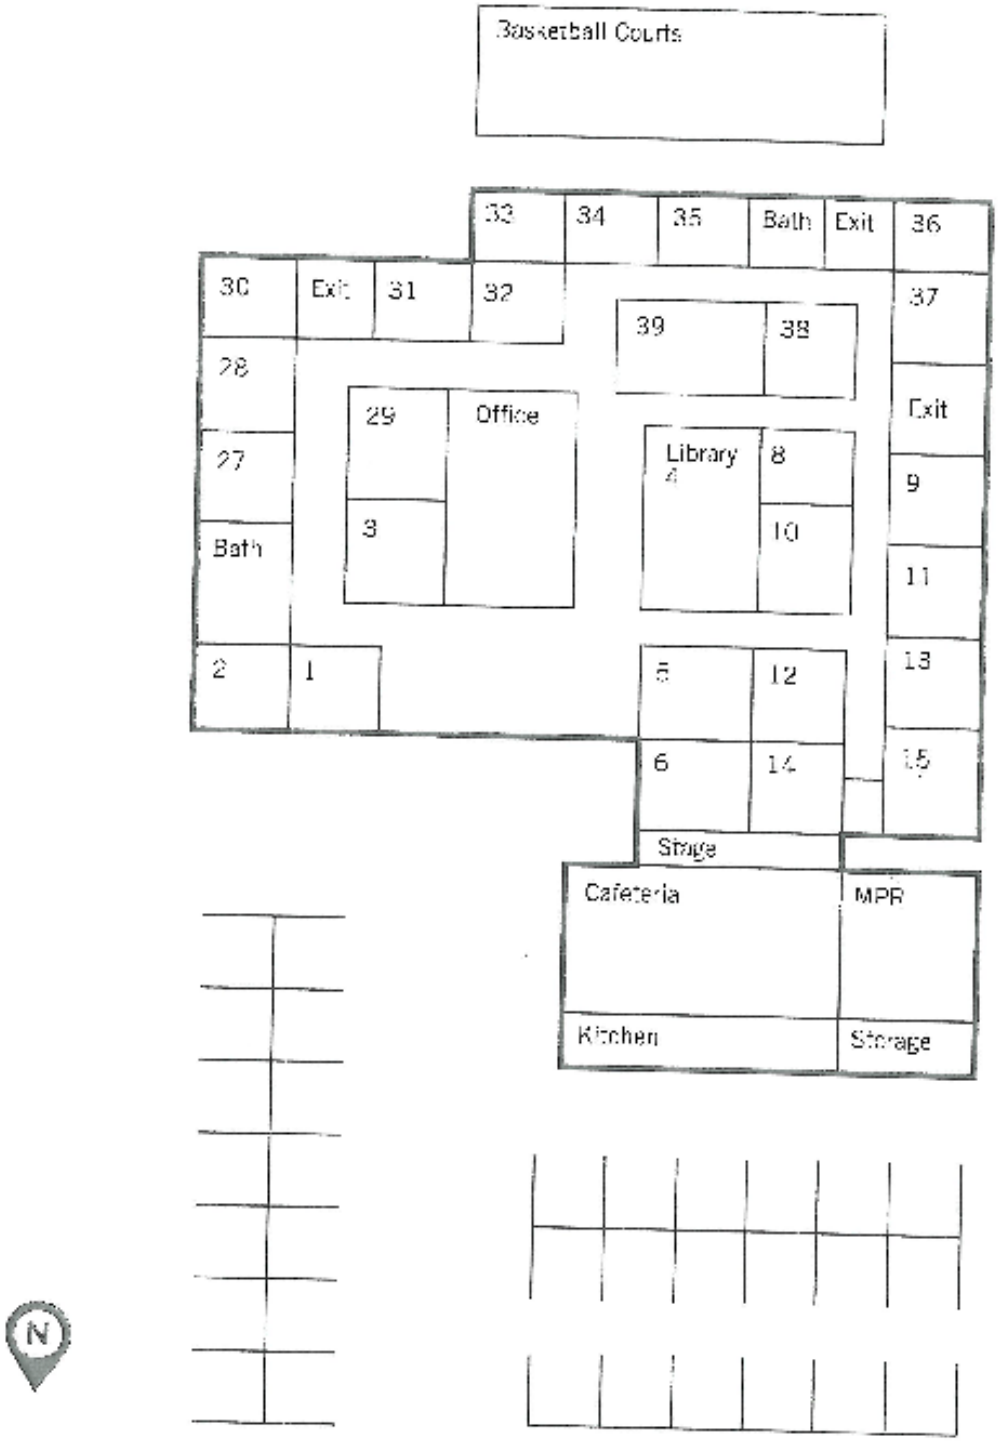
Basketball Courts
33
34
35
Bath
Exit
36
30
Exit
31
32
37
39
38
28
Exit
29
Office
27
Library
4
8
9
3
10
Bath
11
2
1
5
12
13
6
14
15
Stage
Cafeteria
MPR
Kitchen
Storage
N

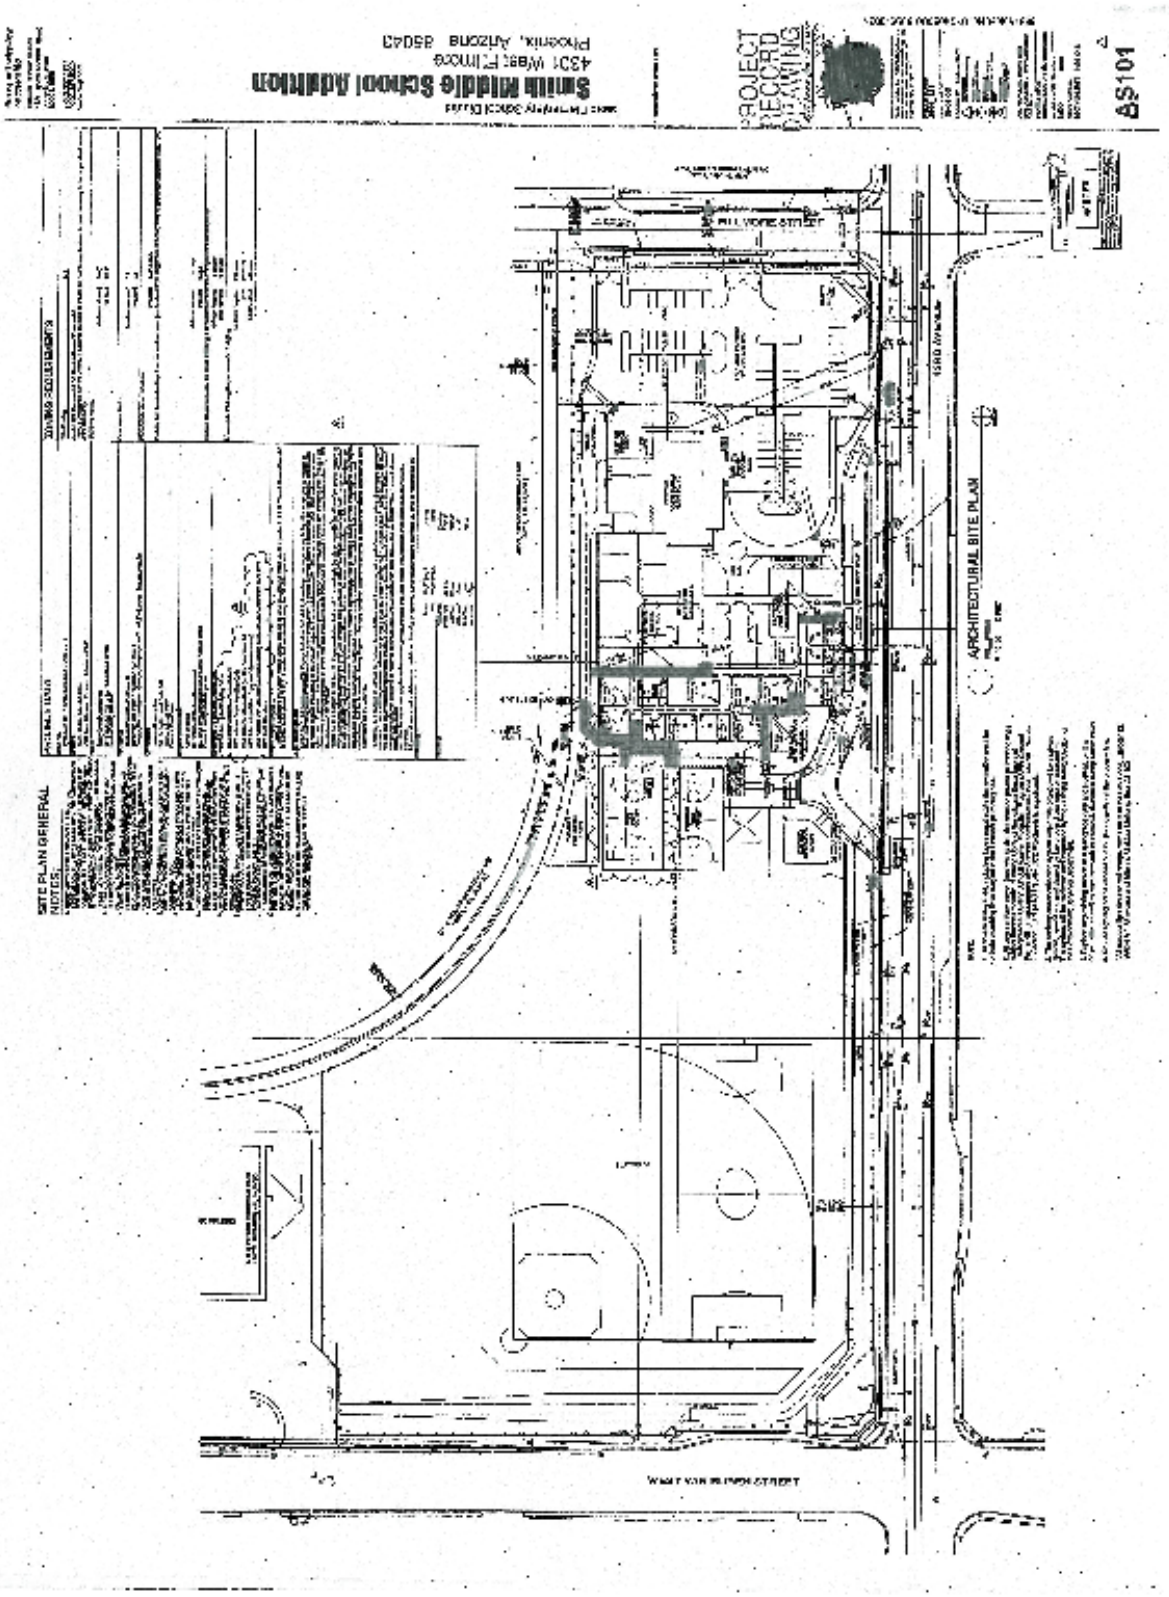
Smith Middle School Addition
4231 West Fillmore
Phoenix, Arizona 85043
PROJECT RECORD DRAWING
AS101
SITE PLAN GENERAL NOTES
ARCHITECTURAL SITE PLAN
FILLMORE STREET
WEST VAN BUREN STREET