Enrollment Cap Notification Request

Charterholder Info

Charter Holder

Name:
The Odyssey Preparatory Academy, Inc.

CTDS:
07-85-61-000

Mailing Address:
6500 South Apache
Buckeye, AZ 85326

› View detailed info

Representative

Name:
Frank Yanez

Phone Number:
602-663-2516

Downloads

Download all files

Enrollment Cap

From:
1700

To:
2000

Attachments

Board Minutes — Download File

Additional Information*
No documents were uploaded.

Increase to Enrollment Cap Attachments

The following 2 attachments are only required if the enrollment cap is increasing.

Documentation that current facilities can accommodate requested capacity — Download File

Narrative describing the staffing changes and recruiting efforts that will be made to reach capacity — Download File

Signature

Charter Representative Signature
Frank Yanez 02/26/2013

6500 S. Apache. Buckeye, AZ 85326
17532 W Harrison Ave Goodyear, AZ 85338

February 26, 2013

To whom it may concern,

The Odyssey Preparatory Academy, Inc. is requesting to increase the CAP for enrollment to 2,000 from 1,700. With the addition of the new site Odyssey Institute for Advanced and International Studies, CTDS 07-85-61-004, the capacity for students has increased by 600. This new facility gives us approximately 22 classrooms for students. Our new site is near capacity and the need for a CAP increase is real to ensure we receive funding for all the students we are educating.

We opened the new site at the beginning of our school year and have all the staff and students already attending since day one. The recruitment efforts we made ensured the success of our enrollment and helped us attract the qualified staff we need to ensure academic success at our school.

Professionally,

Frank Yanez
Charter Holder

Board Minutes

The Odyssey Preparatory Academy

**This agenda was posted on www.theodysseyacademy.com on 9/24/12*

Pursuant to Arizona Revised Statutes (A.R.S.) § 38-431.02, notice is hereby given to the members of The Odyssey Preparatory Academy and to the general public that the Board will hold a meeting, open to the public as specified below. The Board reserves the right to change the order of items on the agenda, with the exception of public hearings set for a specific time. One or more members of the Board may participate in the meeting by telephonic communications.
Pursuant to A.R.S. § 38-431.02(H), the Board may discuss and take action concerning any matter listed on the agenda.
Pursuant to A.R.S. § 38-431.03(A)(3) the Board may vote to go into Executive Session, which will not be open to the public, for legal advice concerning any item on the agenda.
Persons with a disability may request a reasonable accommodation such as a sign language interpreter, by contacting Mary Yanke at (602) 680-0967. Requests should be made as early as possible to allow time to arrange the accommodation.

DATED AND POSTED this 24th day of September, 2012.
TIME OF DAY: 1:00 PM
By_____
Mary G. Yanke

Meeting Location: 6500 S. Apache Road, Buckeye, AZ 85326
September 26, 2012
Meeting Time: 4:30 PM

Chairman: Frank Yanez

Other Board Members: Mary Yanke, Megan Olson, and Holly Johnson

I. Call to order

* Meeting called to order at 4:30 p.m.

II. Roll call – Megan Olson, Mary Yanke, Holly Johnson and Frank Yanez all present

III. Call to public

IV. Open issues

V. New business

Approval of enrollment CAP increase to 2,000

* Olson motions to approve the enrollment CAP increase to 2,000
* Johnson seconds the motion
* Unanimously approved

VI. Adjournment

* Meeting adjourned at 4:44 p.m.

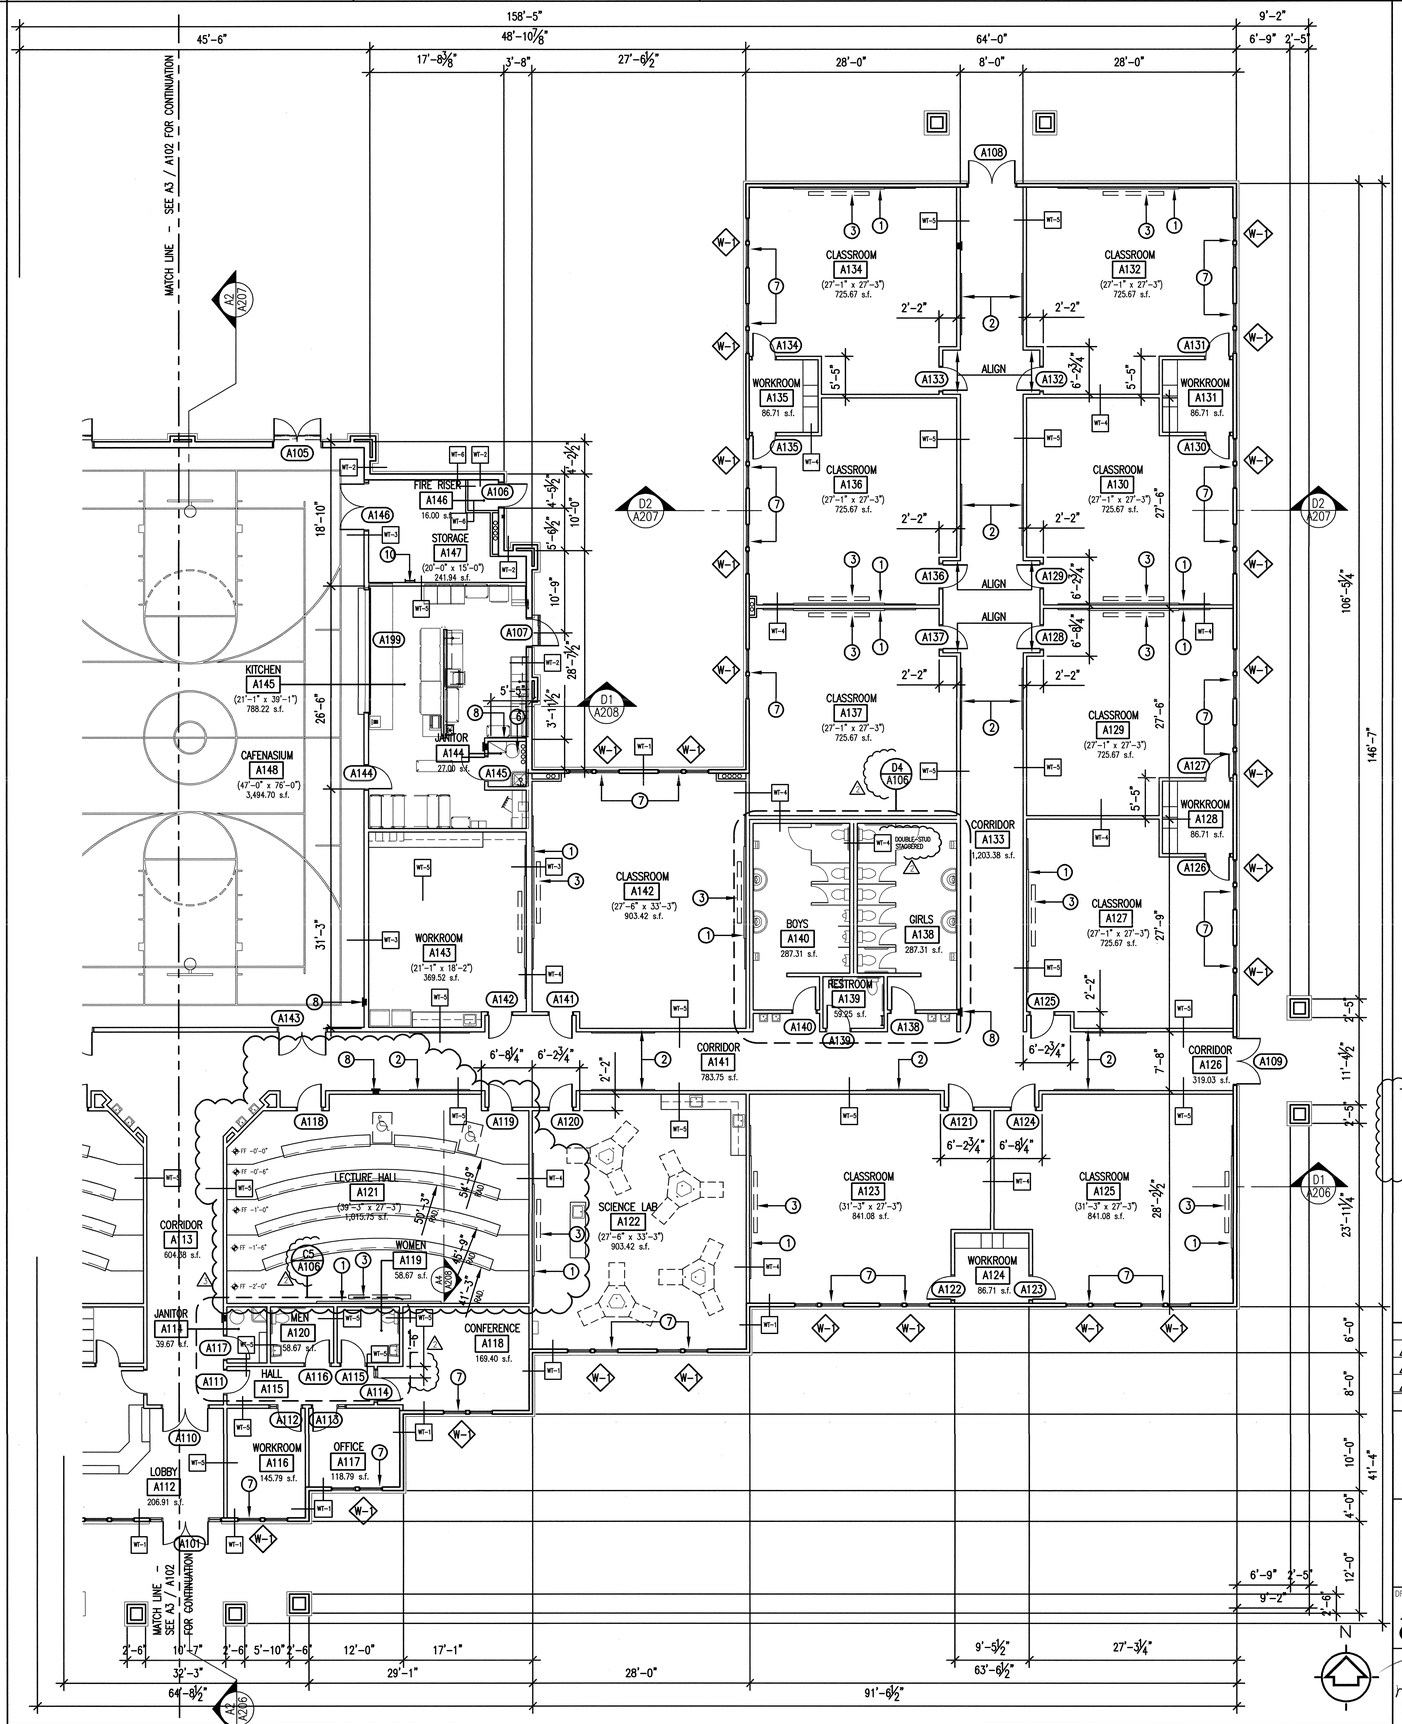

A3 ENLARGED ARCHITECTURAL FLOOR PLAN

1/8" = 1'-0" OVERALL BUILDING SQUARE FOOTAGE AS SHOWN – 34,879 S.F.

KEYED NOTES:

1. 12'-0" WIDE x 4'-0" HIGH WHITE BOARD WITH 4'-0" WIDE x 4'-0" HIGH VINYL FACED TACK BOARD ON EACH SIDE OF WHITE BOARD, MOUNTED AT +3'-0" ABOVE FINISH FLOOR – TYPICAL. (PROVIDE MARKER TRAY AT WHITE BOARD ONLY).
2. 8'-0" WIDE x 4'-0" HIGH VINYL FACED TACK BOARD, MOUNTED DIRECTLY ABOVE CHAIR RAIL (+/- 3'-0" A.F.F.) – TYPICAL.
3. 8'-0" WIDE x 4'-0" HIGH MANUAL PROJECTION SCREENS, MOUNTED AT +7'-6" ABOVE FINISH FLOOR – TYPICAL.
4. 1-1/2" DIAMETER STEEL PIPE HANDRAIL – PAINTED. MOUNT RAILING AT +2'-10" ABOVE STAIR – TYPICAL.
5. 11" WIDE BY 14" HIGH PLATFORM RISER, CONTINUOUS ALONG THE ENTIRE FRONT OF THE PLATFORM – TYPICAL.
6. ELECTRIC HOT WATER HEATER, SEE PLUMBING DRAWINGS FOR EXACT SIZE AND REQUIREMENTS – TYPICAL.
7. HORIZONTAL WINDOW BLINDS AT EACH EXTERIOR WINDOW – TYPICAL (SEE SPECIFICATIONS).
8. 2A:10BC FIRE EXTINGUISHER IN SEMI-RECESSED FIRE EXTINGUISHER CABINET – TYPICAL (SEE SPECIFICATIONS).
9. 16'-0" WIDE x 4'-0" HIGH WHITE BOARD WITH (2) 8'-0" WIDE x 4'-0" HIGH ADDITIONAL SLIDING WHITE BOARD SECTIONS – TYPICAL (SEE SPECIFICATIONS).
10. ROOF ACCESS LADDER WITH LOCKABLE ROOF SCUTTLE – SEE REFLECTED CEILING PLAN AND ROOF PLAN FOR ADDITIONAL INFORMATION – TYPICAL.
11. SELF CONTAINED EMERGENCY EYE WASH STATION – TYPICAL – SEE SPECIFICATIONS.

GENERAL NOTES:

A – CONTRACTOR SHALL VERIFY THE EXACT LOCATION OF ALL EXISTING UNDERGROUND UTILITIES PRIOR TO COMMENCING WITH THIS CONSTRUCTION – TYPICAL.

B – CONTRACTOR SHALL REPAIR AND / OR REPLACE ANY / ALL EXISTING FINISHES THAT ARE DAMAGED DURING THE COURSE OF THIS CONSTRUCTION AT NO ADDITIONAL COST TO OWNER – TYPICAL.

C – NO SMOKING, DRINKING, PROFANITY AND/ OR OTHER ABUSIVE LANGUAGE, CARRYING OF WEAPONS, ETC. SHALL NOT BE TOLLERATED ON THIS CONSTRUCTION SITE – VIOLATORS WILL BE REMOVED FROM THE JOB SITE AND THEIR COMPANY WILL BE NOTIFIED THAT THEY MAY NOT RETURN TO THE SITE – TYPICAL.

D – CONTRACTOR SHALL NOTE THAT NOT ALL KEYNOTES ARE USED ON EACH SHEET – TYPICAL.

E – FOR WALL TYPE SCHEDULE – SEE SHEET A105 – TYPICAL.

TOWN OF BUCKEYE NOTE

1. KITCHEN VENTILATION AND EXHAUST SYSTEMS WILL COMPLY PER IMC SECTIONS 506.1. 507.1, 508.1, AND 509.1. COMMERCIAL KITCHEN USES DO NOT APPLY, ONLY HEATING PROCESSES WILL APPLY.

No.	REVISIONS/SUBMISSIONS	DATE
3	PLAN REVIEW COMMENTS AND CORRECTIONS	03/20/12
2	PLAN REVIEW COMMENTS AND CORRECTIONS	02/27/12
1	OWNER COORDINATION	02/10/12

ODYSSEY FOR ADVANCED STUDIES

BUCKEYE

HIGH SCHOOL CAMPUS

SOUTH AIRPORT ROAD BUCKEYE, ARIZONA 85236

Adolfson & Peterson Construction

5002 SOUTH ASH AVENUE TEMPE, ARIZONA 85282

DRAWING TITLE:

ARCHITECTURAL FLOOR PLAN GENERAL NOTES, DETAILS

REGISTERED ARCHITECT CERTIFICATE NO. 26587 MICHAEL D. SCHUBERT Date Signed 01/25/12 ARIZONA, U.S.A. Expires on 09/30/2013

DESIGNED BY: TDC / MDS	PROJECT NO. 6361-01
DRAWN BY: MDS	SCALE: AS NOTED
CHECKED BY: MDS	DRAWING NO. A103
DATE: 01.25.2012	
DATA FILE: 6361A104.dwg	